




AS-BUILT DOCUMENTATION
OSP Field Construction

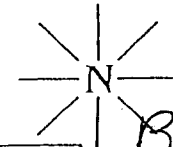

B008351

B08351


Sheet 1 of 1	Dated 5-17-00	Project # 5467	Date 5-17-00
W.O. #	Span CANAL	Title	To

MP/SHT #

NOT TO SCALE

* SPRINT LINE 7' TO BOTTOM
CANAL 10' TO BOTTOM
O/S FROM ~~SPRINT~~ OF RAIL #
CENTER

MP/SHT

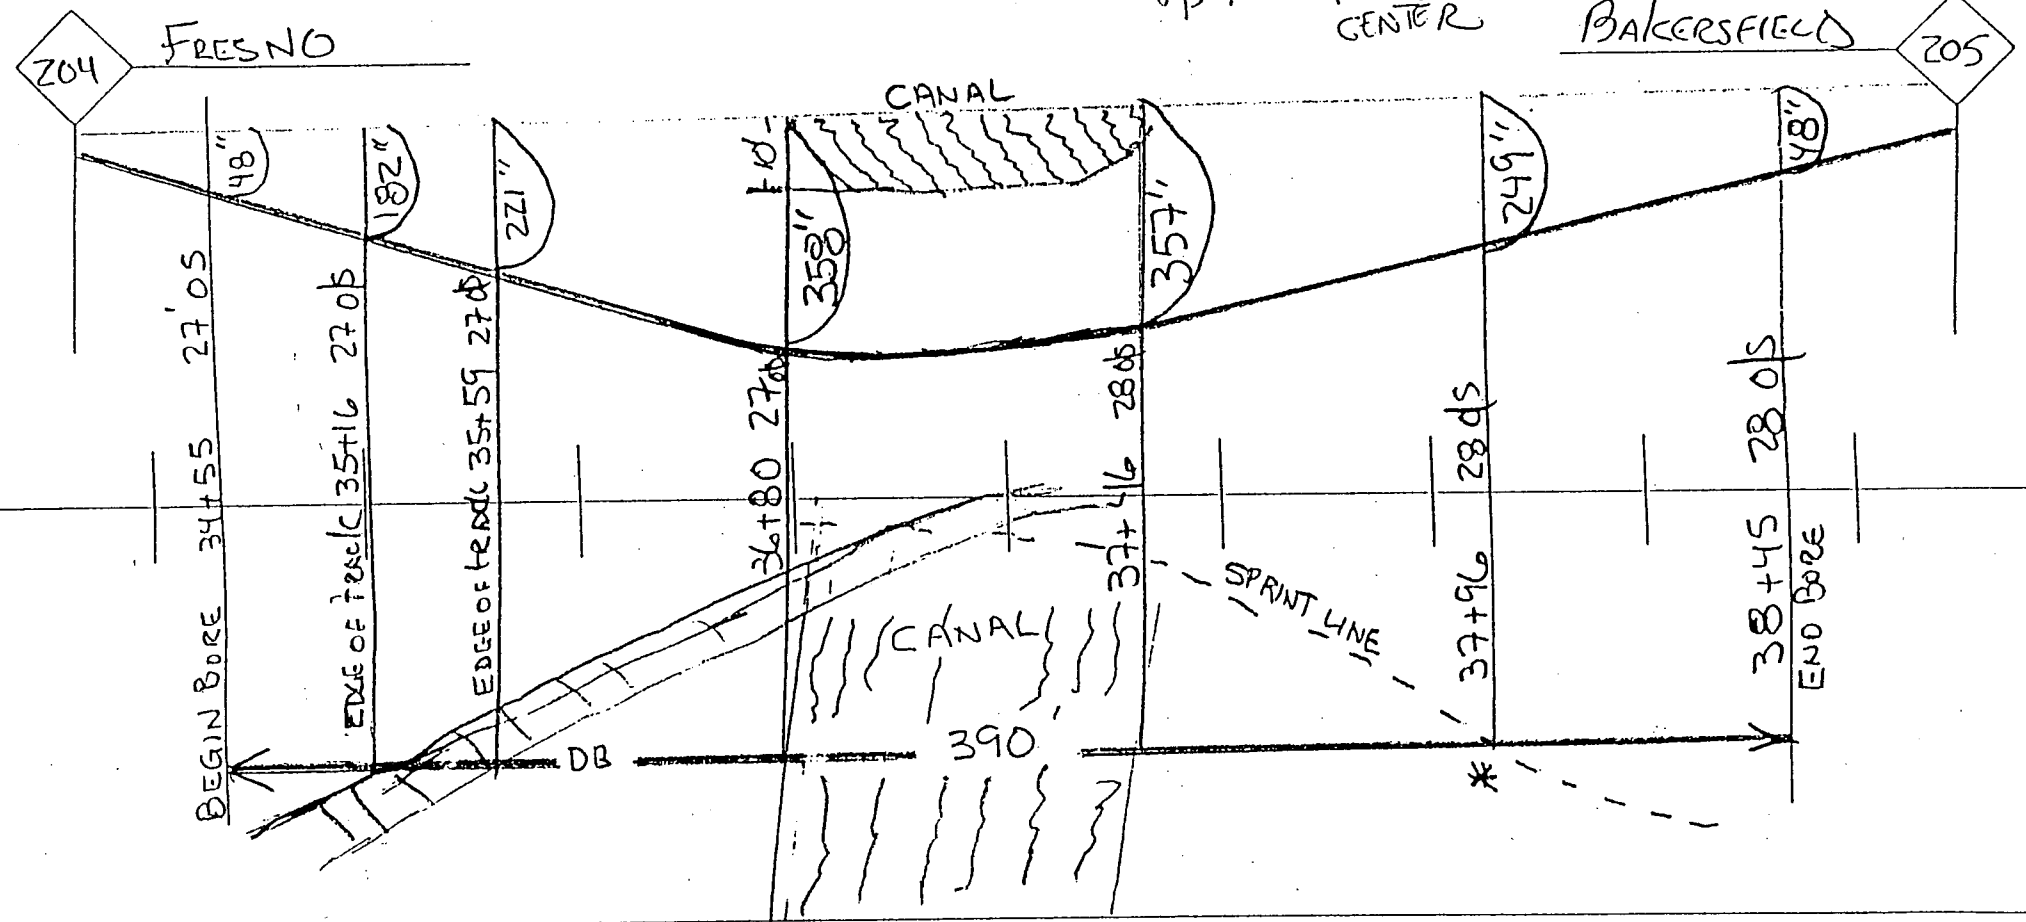


Materials used:	
Construction Contractor	Posted By
Inspector	Engineering Company
Inspection City	Date

B08351

PROFILE INFORMATION


(Inspector to Fill Out)

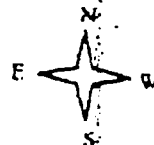

Date: 5-16-08

Road Arroyo Gas Line(s) Electric Line(s) (FOC) (RR Track(s)) River Creek
 Burn Other (Specify): ① RRI CANAL

TOP PLAN

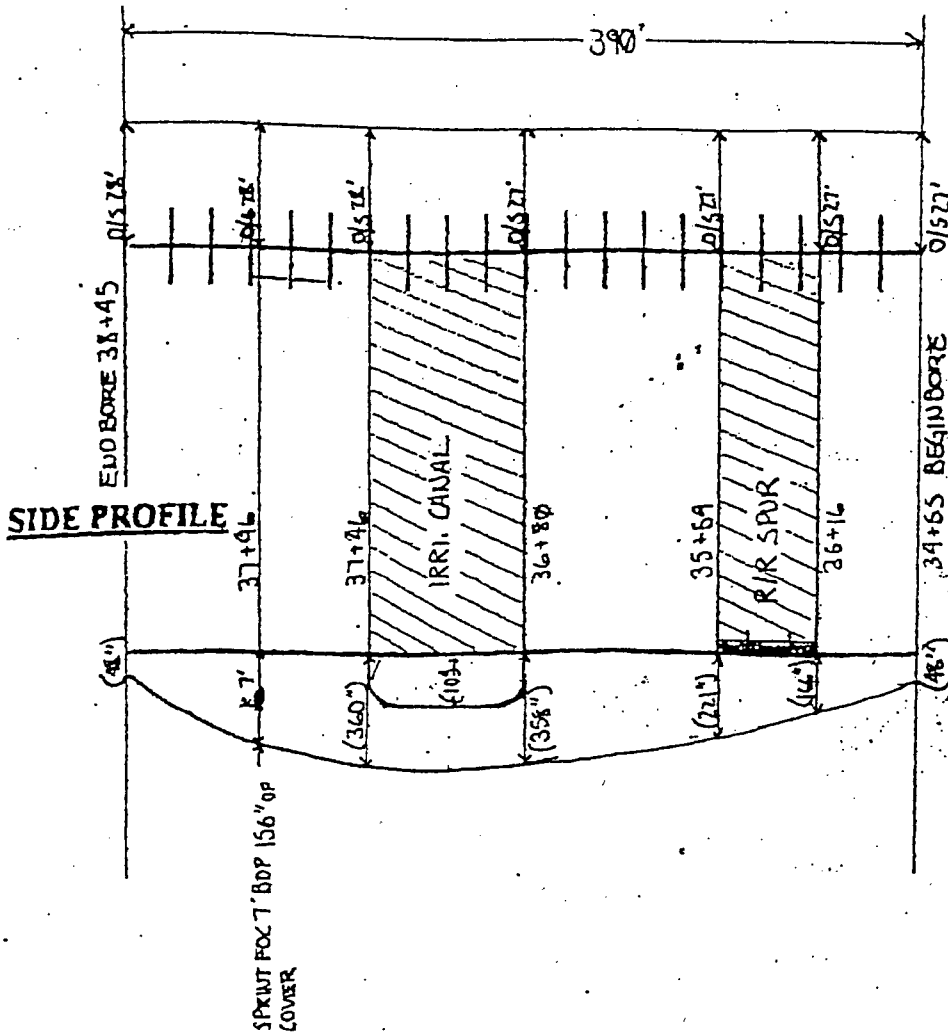

*STEM LIST RUNS SOUTH TO NORTH

# Stem	Pitch%	Depth	O/S	91m*
1	-32	59'	28'	38+45
2	-32	112'	28'	
3	-32	183'	28'	
4	-36	241'	28'	37+46
5	-28	307'	28'	
6	-20	344'	28'	
7	-12	357'	28'	37+46
8	-4	360'	28'	
9	+1	WATER		
10	+3	WATER		
11	+4	WATER		
12	+5	WATER		36+80
13	+5	356'	27'	
14	+10	338'	27'	
15	+12	317'	27'	
16	+12	299'	27'	
17	+10	280'	27'	
18	+12	265'	27'	
19	+12	256'	27'	
20	+14	238'	27'	
21	+12	221'	27'	35+59
22	+12	202'	27'	
23	+12	182'	27'	35+46
24	+12	152'	27'	
25	+10	130'	27'	
26	+12	110'	27'	
27	+18	84'	27'	34+65
28	+24	40'	27'	

BORE SUMMARY

Soil Conditions: (Dir) / Cobble / Rock
 Begin Bore (Sta.): 34+55
 Bore Pay Length: 390'
 Casing Type: N/A
 Duct Pipe Size: 1 1/2"
 Subcontractor: ASI
 Rig #: AZ
 Owner: ASI

Job #: LEVEL THREE IRRIGATION CANAL FRESNO
 End Bore (Sta.): 38+45
 Proofing Pay Length: 390'
 Casing Pay Length: N/A
 # of Ducts: 12
 Foreman Signature: [Signature]
 Inspector Signature: [Signature]